

ZIEGLER CHEMICAL & MINERAL CORP.**LITTLE BONANZA OPERATIONS****STAR ROUTE, VERNAL, UTAH 84078**

Telephone: (435) 789-3593 Fax: (435) 789-3595

December 10, 2006

D. Wayne Hedberg
Permit Supervisor
State of Utah
Department of Natural Resources
Division of Oil, Gas and Mining
1594 West North Temple
P.O. Box 145801
Salt Lake City, Utah 84114-5801

RE: Ammendment to Notice of Intention to Commence Small Mining Operations, Neal State Mine, M0470063,

Dear Mr. Hedberg,

Ziegler Chemical and Mineral Corp. would like to submit an amendment to existing NOI for state lease, Neal Mine, M0470063. The Neal #3 mine is located in Township 11 South, Range 24 East, SL Meridian, Utah in the N $\frac{1}{2}$ SW $\frac{1}{4}$ NW $\frac{1}{4}$ SE $\frac{1}{4}$ in section 32.

In order to access the vein at Neal #3, a new 1,500 foot road was built. Due to the steep terrain, an area was widened for placement of the hoist house, bins, and compressors. Additional area was needed to allow for equipment to haul the ore from the bin.


I have enclosed an operations map that shows mine shafts, roads and the other facilities present at this site.

Thank you,

Valyn Davis
Ziegler Chemical &
Mineral Corp.


cc. Gordon Ziegler, President, Ziegler Chemical & Mineral
Paul Baker, Utah Division of Oil, Gas, & Mining
Will Stokes, SITLA

RECEIVED
DEC 22 2006
DIV. OF OIL, GAS & MINING

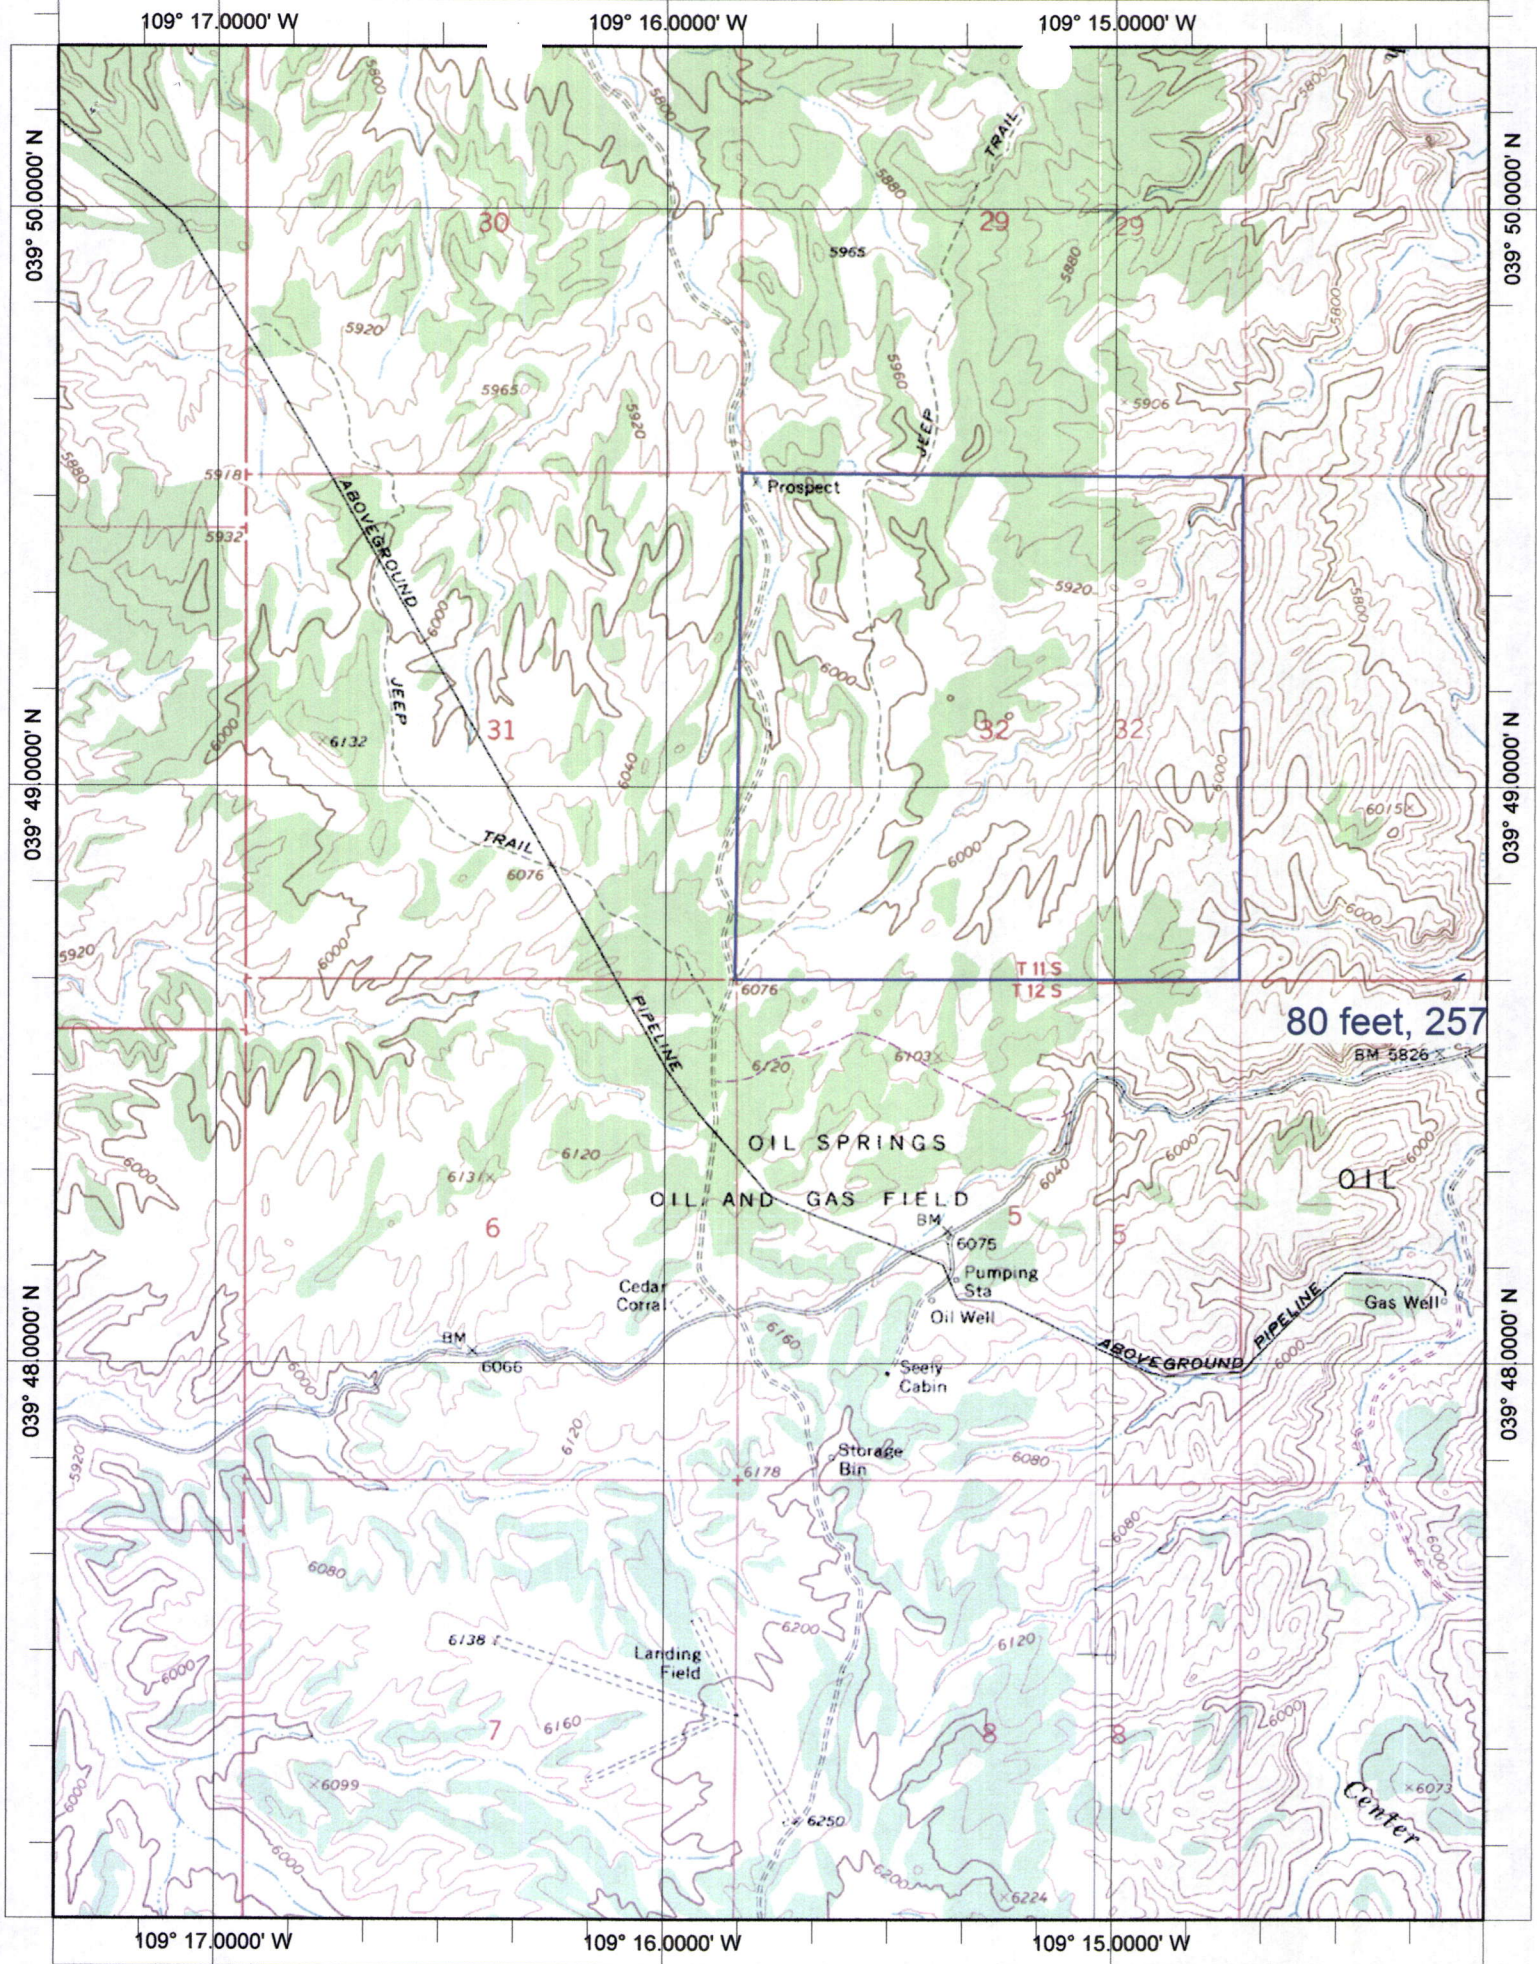

STATE OF UTAH DIVISION OF OIL, GAS, & MINING
 DETAILED PLAN MAP SHOWING AREAS OF DISTURBANCES
 NEAL MINE OF ZIEGLER CHEMICAL & MINERAL CORPORATION
 LEASE NUMBER: ML-47536 OBA

MAP SCALE
 1" = 100'

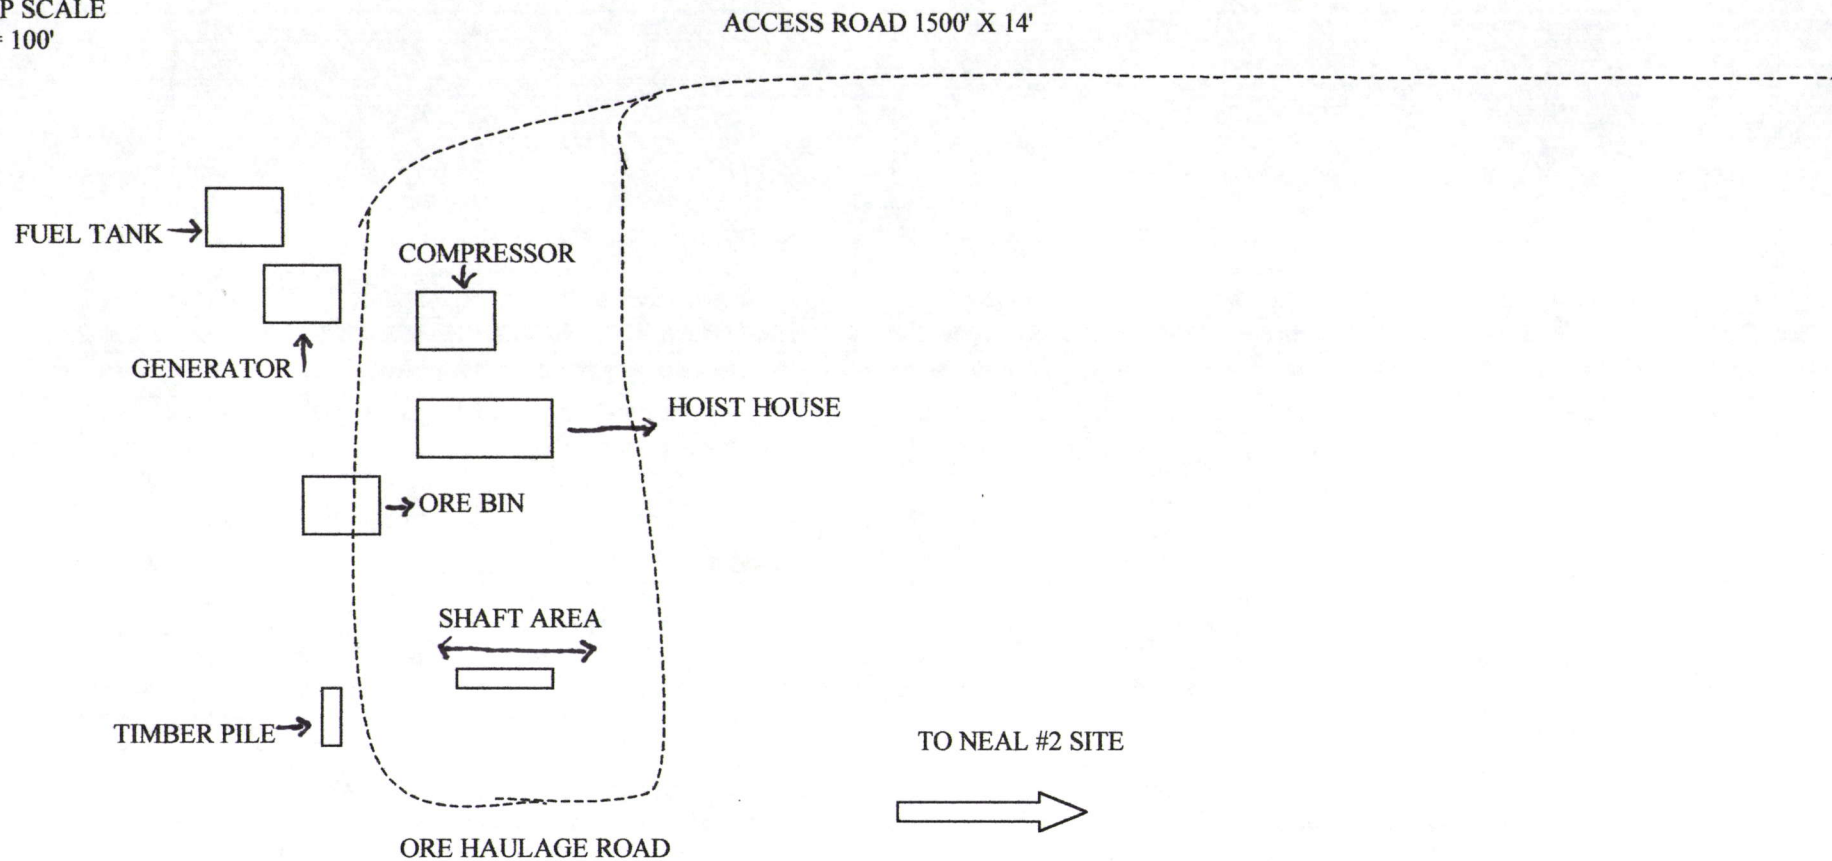

NEAL #2 AND NEAL #3 SITE
 DISTURBANCE AREA:
 THE TWO MINE SITES (150 X
 300 X 2 / 43,560 SQ. FT.) AND
 THE TWO NEW ROAD WAYS
 (1,500 X 14 X 1,000 X 14 / 43,560
 SQ. FT.)
 TOTAL DISTURBANCE AREA:
 APPROX. 3.2 ACRES